




Panasonic WY-CW314L Color Camera (PAL)

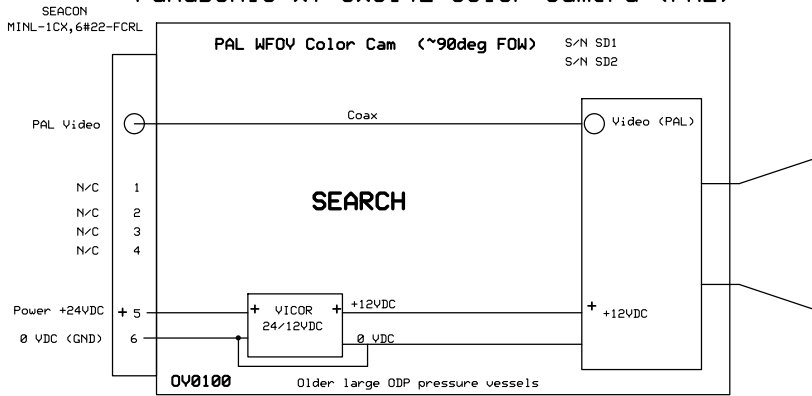

IMENCO OE14 P/T/Z (HD-SDI)

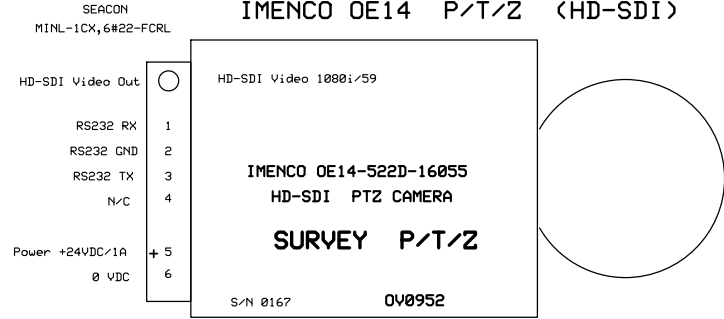


CABLE
MINL-1CX,6#22

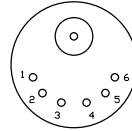


Looking into face of Cable connector

BULKHEAD CONNECTOR
MINL-1CX,6#22-FCRL

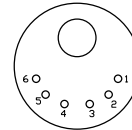

Looking into face of Bulkhead connector

FCB X20D (NTSC)

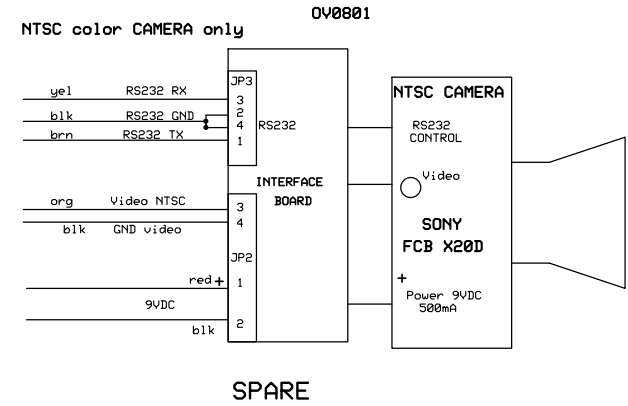

AS BUILT

IODP		
CAMERAS		
MEIRING	032020	Page 17