



Panasonic WY-CW314L Color Camera (PAL)

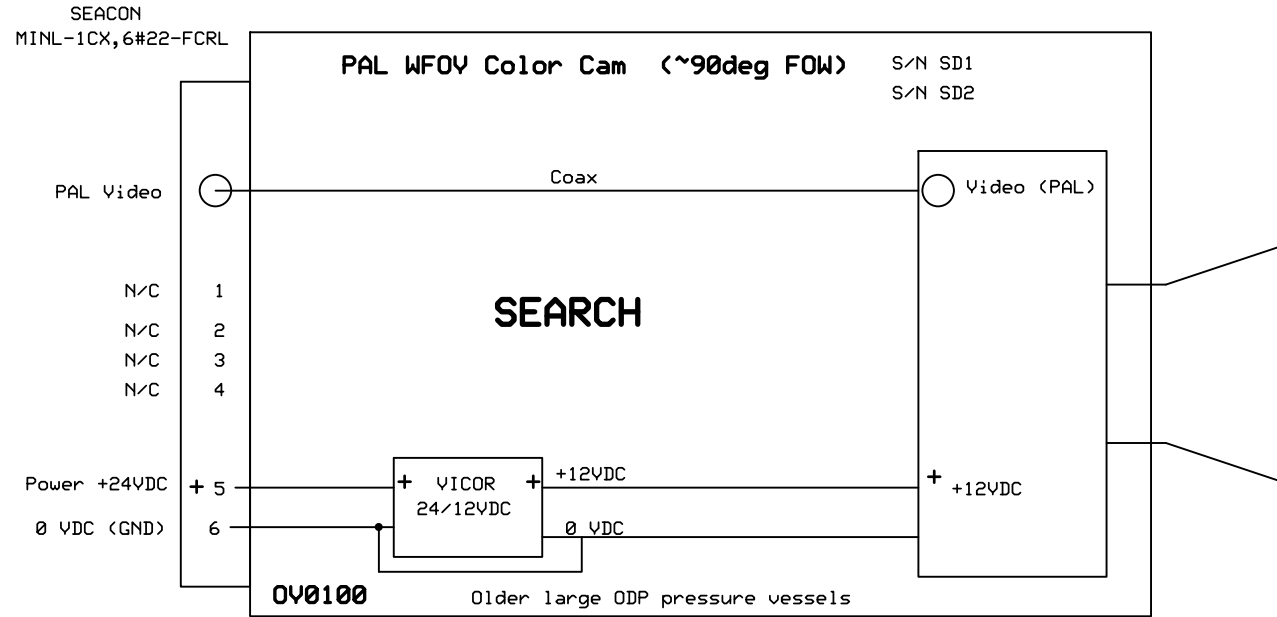


CABLE
MINL-1CX,6#22

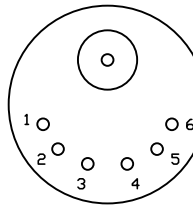


Looking into face of Cable connector

BULKHEAD CONNECTOR
MINL-1CX,6#22-FCRL

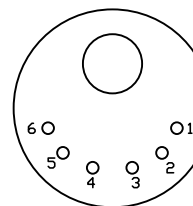

Looking into face of Bulkhead connector



IMENCO OE14 P/T/Z (HD-SDI)

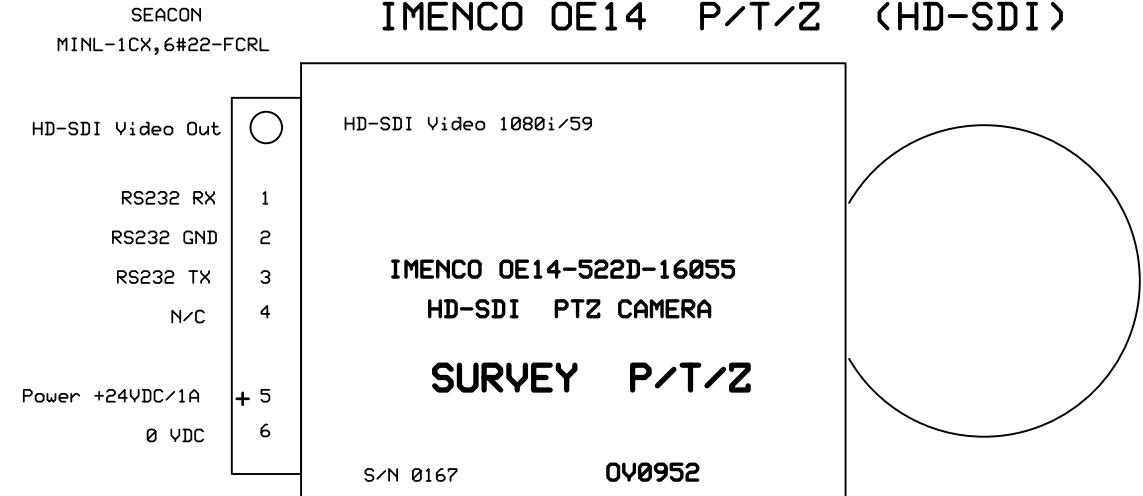

FCB X20D (NTSC)

OV0801

NTSC color CAMERA only

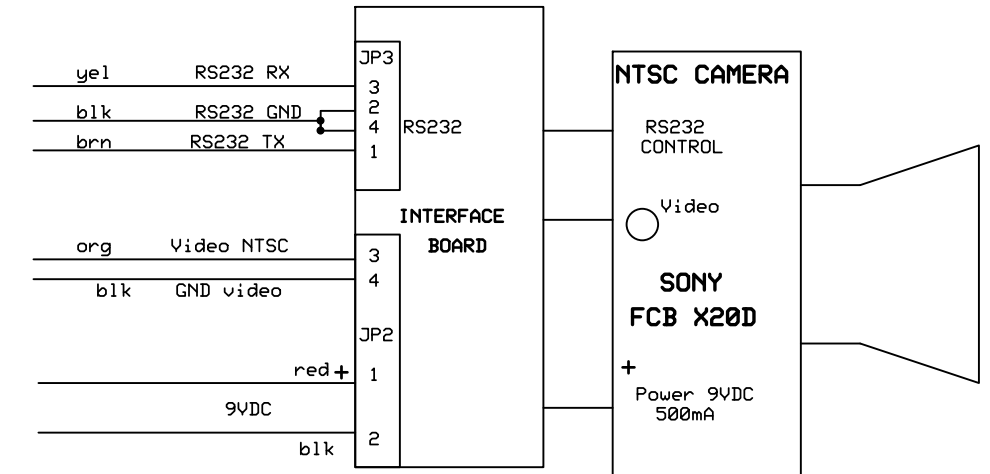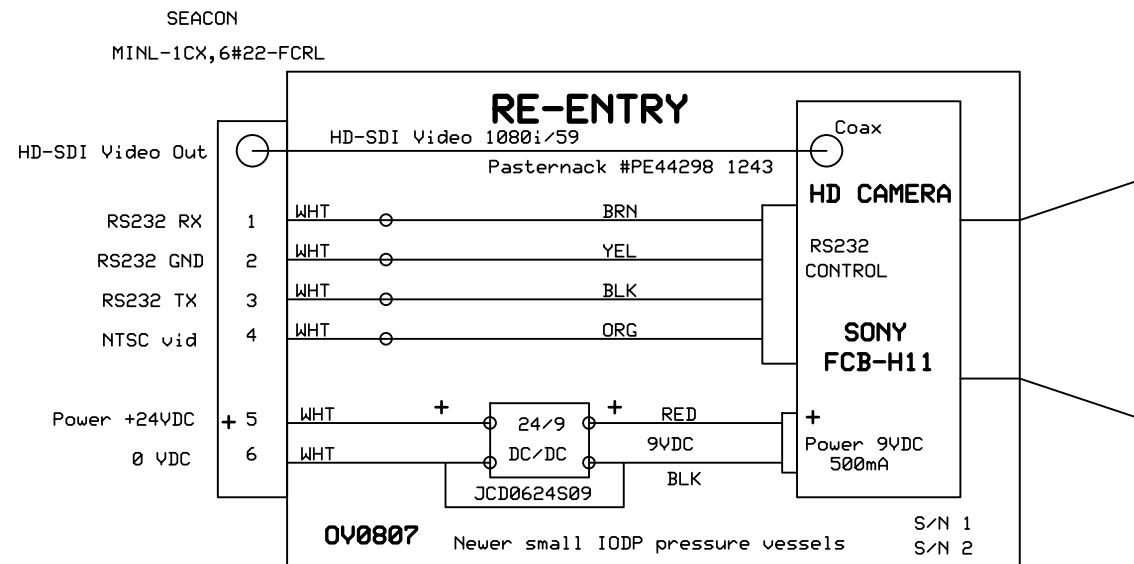

AS BUILT

IODP		
CAMERAS		
MEIRING	032020	Page 17