


# AS BUILT

SFP		SFP	
LOCAL (SURFACE)		REMOTE (POD)	
ABL45-24-80-D	1000Base-BX-U Tx 1490/Rx 1550 80km DDM	ABL54-24-80-D	1000Base-BX-D Tx 1550/Rx 1490 80km DDM
ASF55-24-80-D	1.25G CWDM 1550nm 80km DDM	ASF57-24-80-D	1.25G CWDM 1570nm 80km DDM
ASF51-24-80-D	1.25G CWDM 1510nm 80km DDM	ASF53-24-80-D	1.25G CWDM 1530nm 80km DDM
YACRR-XX3X-1L4D	3G Video SFP CWDM 40km DDM	YACTT-5557-1L4D	3G Video SFP CWDM 1550/1570nm 40km DDM

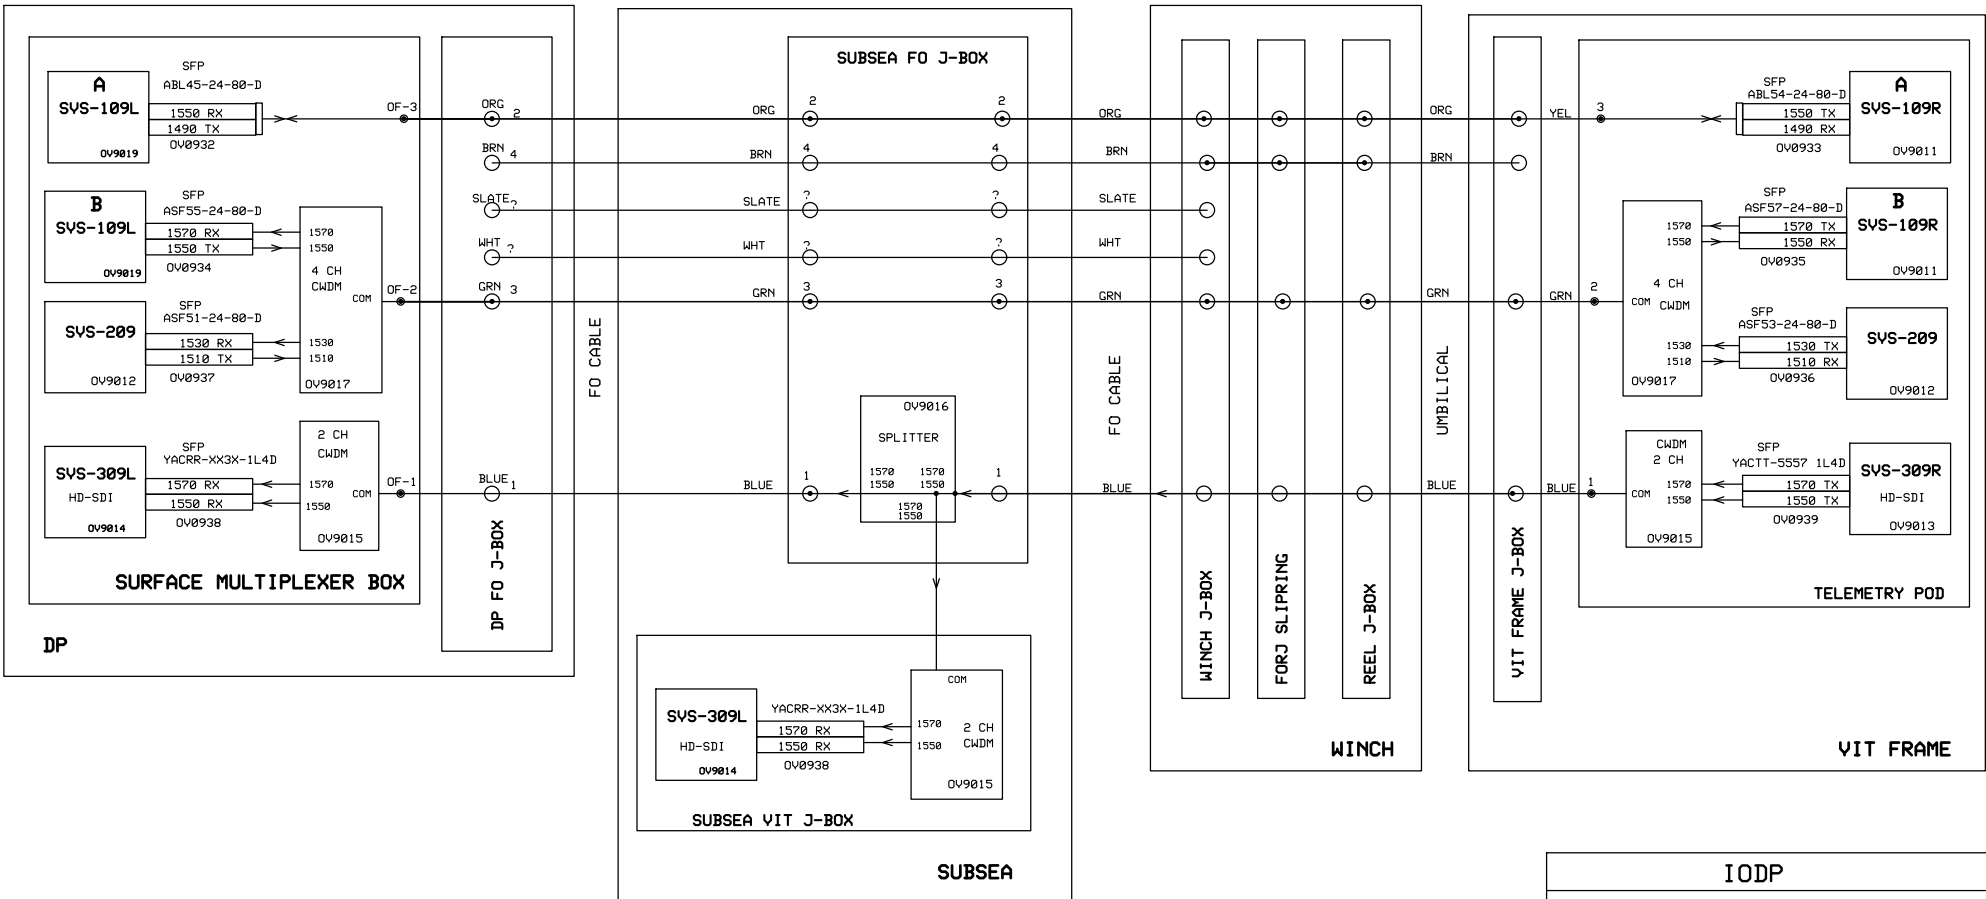

IODP		
OPTICAL LINK		
Mearing	032020	Page 7